

ITEM	PART NO	RECD	DESCRIPTION	MATERIAL
4	251652	1	BRAIDED FLEX HOSE, 1/2" ID X 3" LIVE LENGTH, 12mm X 1/2" ELBOW WELD ENDS	
3	-	1	TUBE 2, PER ASTM A269	
2	-	1	TUBE 1, PER ASTM A269	SS 304L
1	-	1	FLANGE	

NOTES: (UNLESS OTHERWISE SPECIFIED)

- THIS IS A CRYOGENIC VACUUM COMPONENT.
- WELDING PROCEDURE: PER VENDOR SPECIFICATION WITH LBNL APPROVAL.
- CLEANING PROCEDURE: PER VENDOR SPECIFICATION WITH LBNL APPROVAL.
- PACKAGING AND STORAGE PROCEDURE OF THE COMPONENTS: PER VENDOR SPECIFICATION WITH LBNL APPROVAL.
- DIMENSIONS AND TOLERANCING PER ANSI Y14.5M-1982. UNITS ARE IN INCHES UNLESS OTHERWISE SPECIFIED.
- USE OF SULFUR OR SILICONE BEARING OILS, LUBRICANTS, OR COOLANTS ARE STRICTLY PROHIBITED.
- USE OF RESIN OR RUBBER BONDED ABRASIVES UNDER POWER IS STRICTLY PROHIBITED. USE VITREOUS BONDED ABRASIVES ONLY.
- VENDOR SUGGESTED CHANGES TO WELD PREPS; SUBJECT TO LBNL APPROVAL.
- ELBOWS MAY BE USED ON THE TUBE BENDS AS NEEDED.
- COMPOUND BENDS MAY BE MADE TO TWO SEPARATE BENDS UPON LBNL APPROVAL.
- VENDOR SUGGESTED CHANGES TO TOLERANCES TO FACILITATE FABRICATION OR ASSEMBLY; SUBJECT TO LBNL APPROVAL.
- REMOVE ALL THE BURRS AND REAM THE ENDS FOR CIRCULARITY AND CLEAN ENDS.
- TUBE END SURFACE MUST BE PERPENDICULAR TO THE TUBE AXIS WITHIN +/- .010.



- ~~PERFORMANCES:~~ **14. PERFORM ACCEPTANCE TESTS PER SECTION 3.2 OF LBNL SPECIFICATION M856.**
- ~~PERFORMANCES PER LBNL ACCEPTANCE CRITERIA SEE SPECIFICATION NUMBER LBNL N. M8056 AND BY VENDOR AND LBNL APPROVED SPECIFICATION.~~
- ~~OPERATING TEMPERATURE 4.2°K~~
- ~~THERMAL SHOCK WELDS TO LN TEMPERATURE 2 TIMES ONE HOUR INTERVAL~~
- ~~TEST PRESSURE 375 PSIG~~
- ~~VACUUM CHECK WITH HELIUM LEAK MASS SPECTROMETER DETECTOR. THE LEAK RATE AT ANY LOCATION SHALL NOT EXCEED 1 X 10⁻⁹ STD CC/SEC.~~
- EST. WT.: 4.118 LB
- ~~NOMINAL INTERCONNECT PLANE LOCATION. WHERE PIPE IS TO BE CUT DURING INSTALLATION.~~
- ~~MUST HAVE 1.0" MIN CLEARANCE PLANE FOR PIPE WELDER USED DURING INSTALLATION.~~
- ~~PIPE MUST HAVE 1.0" OF LINEAR TRAVEL THROUGH THE SUPPORT SPIDER IN BOTH DIRECTIONS.~~
- 16. THE NOMINAL INTERCONNECT PLANE IS A LOCATION THAT WILL BE UTILIZED DURING FINAL INSTALLATION OF THE FEEDBOX ASSEMBLY. MARK, SCRIBE OR ETCH LOCATION IN A PERMANENT MANNER, SUBJECT TO LBNL APPROVAL, TO AN ACCURACY OF +/- 0.063".**
- 17. PROVIDE A MINIMUM LENGTH OR 4.0" OF STRAIGHT, SMOOTH PIPE ON THE INDICATED SIDE OF THE INTERCONNECT PLANE FOR PIPE WELDING DURING FINAL INSTALLATION OF THE FEEDBOX ASSEMBLY.**
- 18. PIPE MUST BE STRAIGHT AND SMOOTH (NO BUMPS) FOR 0.5" ON EITHER SIDE OF THE CENTER-PLANE OF THE SPIDER SUPPORT.**
- 19. CAP BOTH ENDS OF PIPE AFTER ACCEPTANCE TESTS PER SECTION 3.2 OF LBNL SPECIFICATION M856.**

10. COMPOUND BENDS MAY BE MADE IN TWO SEPERATE BENDS UPON LBNL APPROVAL.

This wording seems awkward, or I just don't understand what is intended.

Does this "cut" refer to CERN's cut at final installation? If so, this will confuse the vendor, who might think he should cut during installation. Note 16 should be clarified.

Again, does this refer to installation at CERN or at the vendor. The vendor may not need 4 inches clearance and so ignore this note.

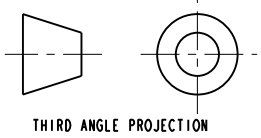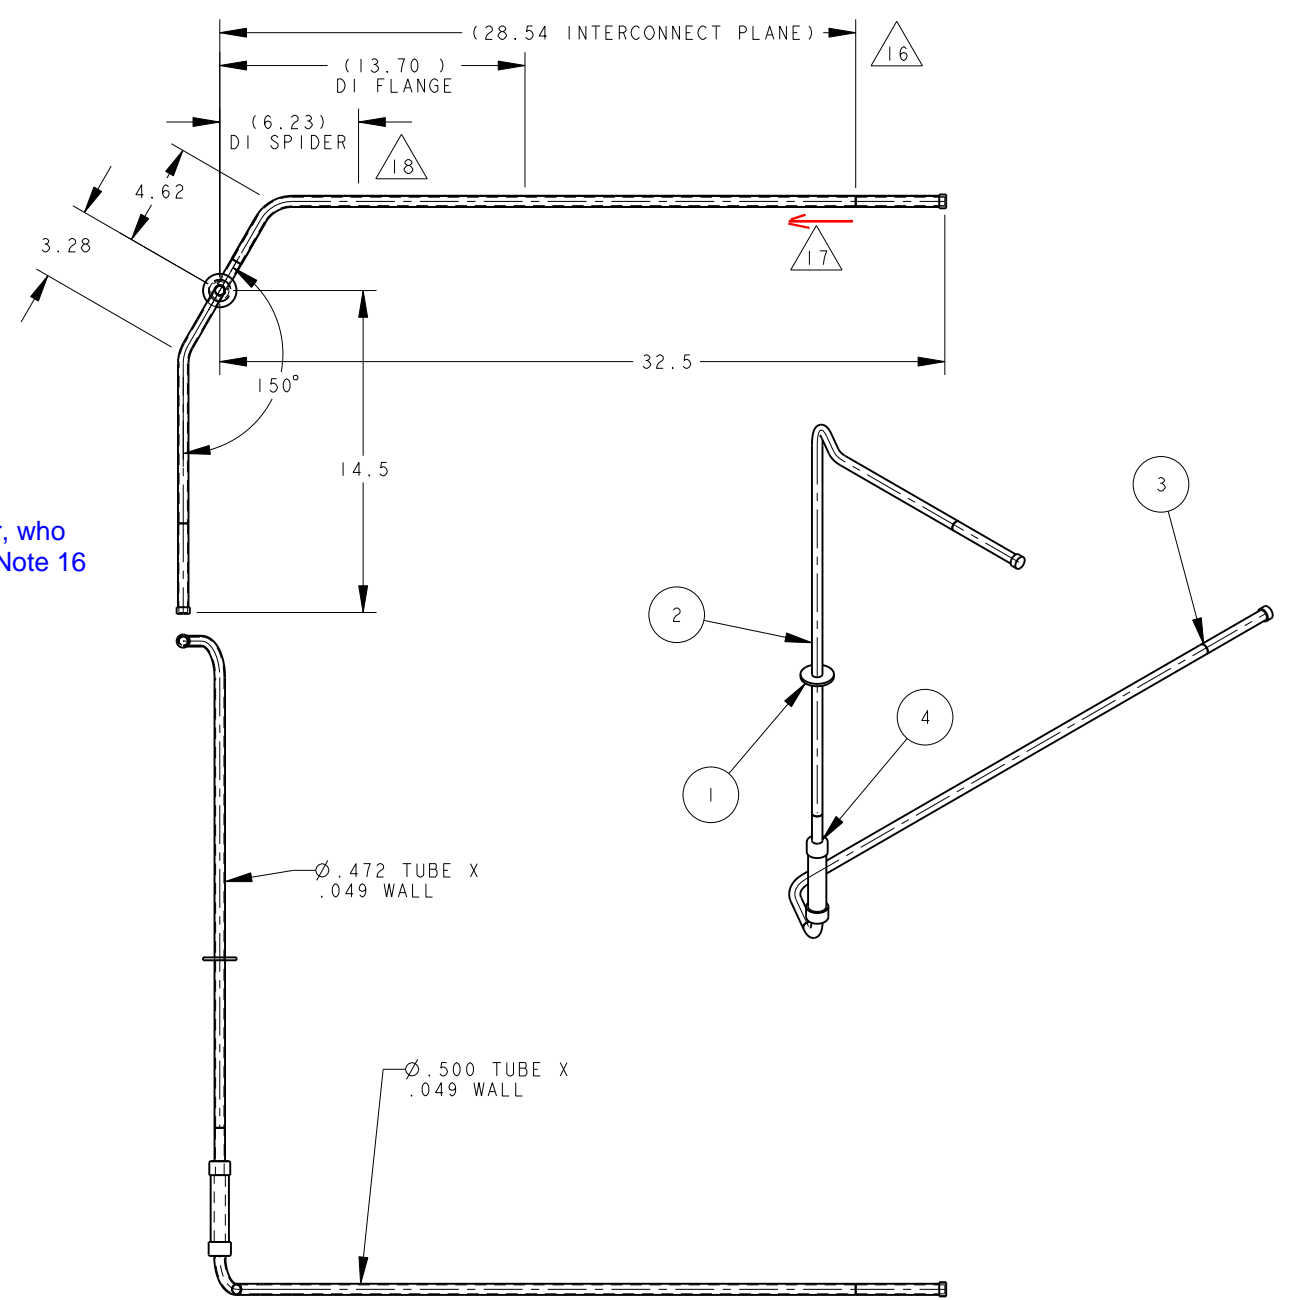

REV	DWG	CHK	ZONE	DATE	CHANGES
A	JR			7/15/02	CHANGES PER PRODUCTION READINESS REVIEW
					CHANGES

UNLESS OTHERWISE SPECIFIED		SHOP ORDERS		SER. NO.	
X.X ± 0.1	FRAC. ± 1/64	ACCT. NO.	NO.	DATE	ISSD
X.XX ± 0.03	Angles ± 1.00°	DEL. TO	DATE	DATE	RECD
X.XXX ± 0.010	FINISH 125 V _{max}	SURFACE TREATMENT			
DO NOT SCALE PRINT		IDENT. TAG			
THREADS ARE CLASS 2		PROJECT NUMBER			
CHAMFER ENDS OF ALL SCREW THREADS 30°		PROJECT NAME			
CUT ROUNDS, 1.5 THREAD RELIEF ON MACHINED THREADS		DWG. R. LA MANTIA		DATE 12-Dec-01	
BREAK EDGES .016 MAX. ON MACHINED WORK		CHK. BY Jon Zbasnik		DATE 19-Mar-02	
REMOVE BURRS, WELD SPATTER & LOOSE SCALE		APR. BY Jon Zbasnik		DATE 19-Mar-02	
IN ACCORDANCE WITH ANSI Y14.5M & B46.1		PATENT CLEAR:			

ERNEST ORLANDO LAWRENCE BERKELEY NATIONAL LABORATORY		UNIVERSITY OF CALIFORNIA - BERKELEY	
LHC IR FEEDBOX CRYOGENICS PIPE, CY2			
MICROFILMED:	DWG. TYPE ASSEM	SHOWN ON 251226	SCALE: 1/4
DESIGN ACCT. NO. Z5LCE2		CATEGORY CODE LH2003	DO NOT SCALE PRINTS
DWG. NO. 2512154		SHEET 1 OF 1	
SIZE 1		REV. 1	

NAME: DULIE OBJECT: 251215 DATE: 13-Jul-02 20:56:30