

Daryl Oshatz

Tom Peterson

NAME: DULIE OBJECT: 251652 DATE: 13-Jul-02 22:01:34

NOTES: (UNLESS OTHERWISE SPECIFIED)

1. THIS IS A CRYOGENIC VACUUM COMPONENT.
2. WELDING PROCEDURE: PER VENDOR SPECIFICATION WITH LBNL APPROVAL.
3. CLEANING PROCEDURE : PER VENDOR SPECIFICATION WITH LBNL APPROVAL.
4. PACKAGING AND STORAGE PROCEDURE OF THE COMPONENTS: PER VENDOR SPECIFICATION WITH LBNL APPROVAL.
5. DIMENSIONS AND TOLERANCING PER ANSI Y14.5M-1982. UNITS ARE IN INCHES UNLESS OTHERWISE SPECIFIED.
6. USE OF SULFUR OR SILICONE BEARING OILS, LUBRICANTS, OR COOLANTS ARE STRICTLY PROHIBITED.
7. USE OF RESIN OR RUBBER BONDED ABRASIVES UNDER POWER IS STRICTLY PROHIBITED. USE VITREOUS BONDED ABRASIVES ONLY.
8. VENDOR SUGGESTED CHANGES TO WELD PREPS; SUBJECT TO LBNL APPROVAL.
9. ELBOWS MAY BE USED ON THE TUBE BENDS AS NEEDED.
11. VENDOR SUGGESTED CHANGES TO TOLERANCES TO FACILITATE FABRICATION OR ASSEMBLY; SUBJECT TO LBNL APPROVAL.
12. REMOVE ALL THE BURRS AND REAM THE ENDS FOR CIRCULARITY AND CLEAN ENDS.
13. TUBE END SURFACE MUST BE PERPENDICULAR TO THE TUBE AXIS WITHIN +/- .010.


~~14. PERFORMANCES:~~ **14. PERFORM ACCEPTANCE TESTS PER SECTION 3.2 OF LBNL SPECIFICATION M856.**

~~PERFORMANCES PER LBNL ACCEPTANCE CRITERIA SEE SPECIFICATION NUMBER LBNL NO. M8056 AND BY VENDOR AND LBNL APPROVED SPECIFICATION.~~

- ~~a) OPERATING TEMPERATURE 4.2°K.~~
- ~~b) THERMAL SHOCK WELDS TO LN TEMPERATURE 2 TIMES ONE HOUR INTERVAL.~~
- ~~c) TEST PRESSURE 375 PSIG.~~
- ~~d) VACUUM CHECK WITH HELIUM LEAK MASS SPECTROMETER DETECTOR. THE LEAK RATE AT ANY LOCATION SHALL NOT EXCEED 1×10^{-9} STD CC/SEC.~~

~~15. EST. WT.: WEIGHT. LB~~

DESCRIPTION	MATERIAL	MAT. LOCATION
	SS 316L????	

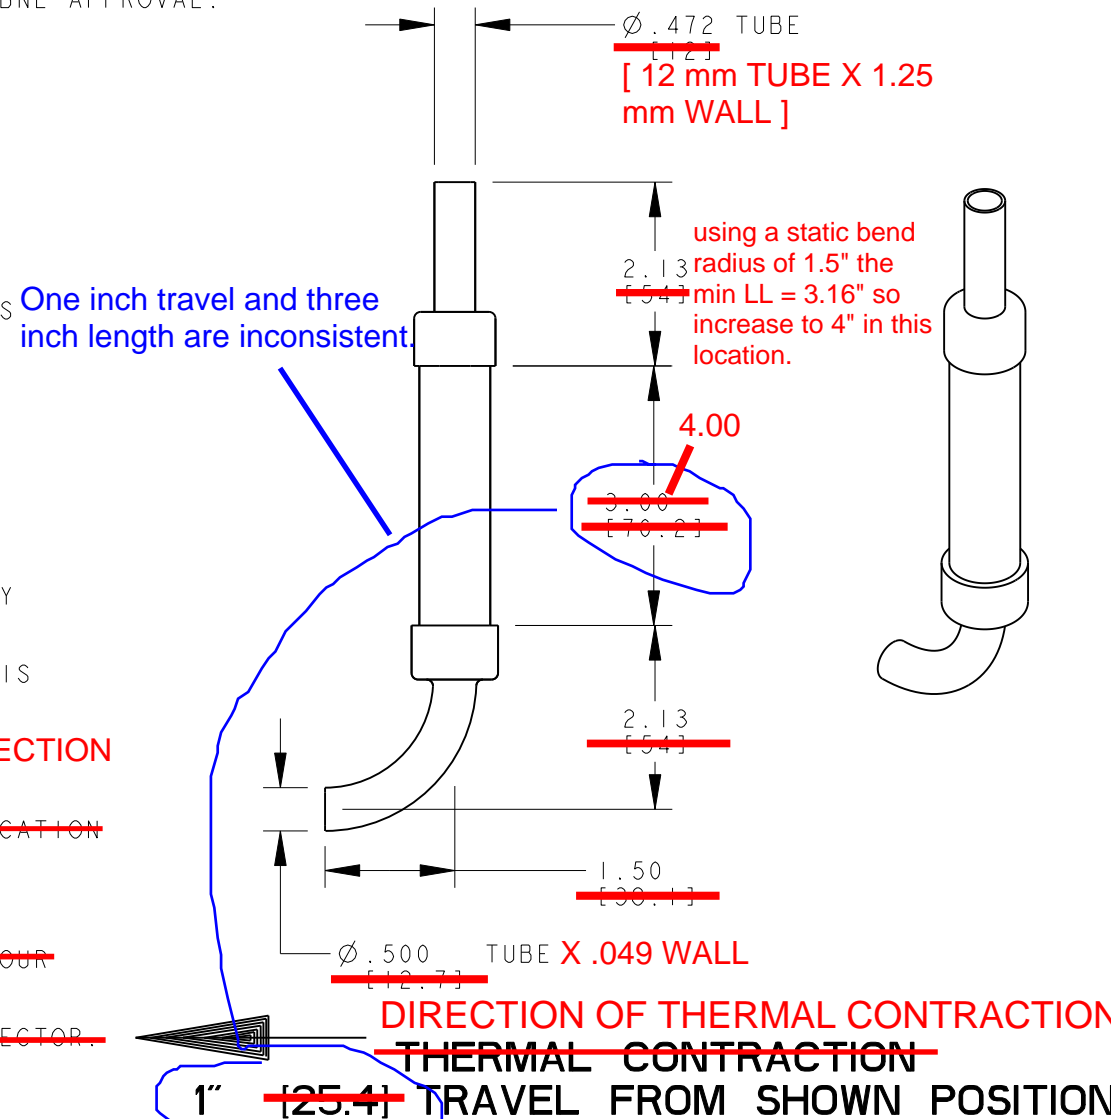

				UNLESS OTHERWISE SPECIFIED		SHOP ORDERS		SER. NO. -		ERNEST ORLANDO LAWRENCE BERKELEY NATIONAL LABORATORY	
				TOLERANCES		ACCT. NO. NO. REQ.		DATE ISSD		UNIVERSITY OF CALIFORNIA - BERKELEY	
				X.X ± 0.1		FRAC. ± 1/64		DATE RECD		LHC IR FEEDBOX CRYOGENICS	
				X.XX ± 0.03		Angles ± 1.00°		SURFACE TREATMT		BRAIDED FLEX HOSE, 1/2" ID X 3" LIVE LENGTH, 12mm X 1/2" ELBOW WELD ENDS	
				X.XXX ± 0.010		FINISH 125/√RMS		IDENT. METHOD TAG		MICROFILMED: DWG. TYPE PART SHOWN ON VARIOUS SCALE: 3/4 DO NOT SCALE PRINTS	
				DO NOT SCALE PRINT		PROJECT NUMBER N/A		PROJECT NAME		SHEET 1 OF 1	
				THREADS ARE CLASS 2		PROJECT NAME		DWG. BY A. HARRIS DATE 13-Jul-02		PATENT CLEAR: DESIGN ACCT. NO. Z5LCE2 CATEGORY CODE LH2003 DWG. NO. 2516523 SIZE 1 REV. 1	
				CHAMFER ENDS OF ALL SCREW THREADS 30°		PROJECT NAME		CHK BY J. ZBASNIK DATE			
				CUT ROUND, 1.5 THREAD RELIEF ON MACHINED THREADS		PROJECT NAME		APR BY J. ZBASNIK DATE			
				BREAK EDGES .016 MAX. ON MACHINED WORK		PROJECT NAME					
				REMOVE BURRS, WELD SPLATTER & LOOSE SCALE		PROJECT NAME					
				IN ACCORDANCE WITH ASME Y14.5M & B46.1		PROJECT NAME					
REV	DWG	CHK	ZONE	DATE	CHANGES						

DWG. NO. 2516523

SIZE REV. 1 1