As-Built_FatCube_COIL_SET.dxf

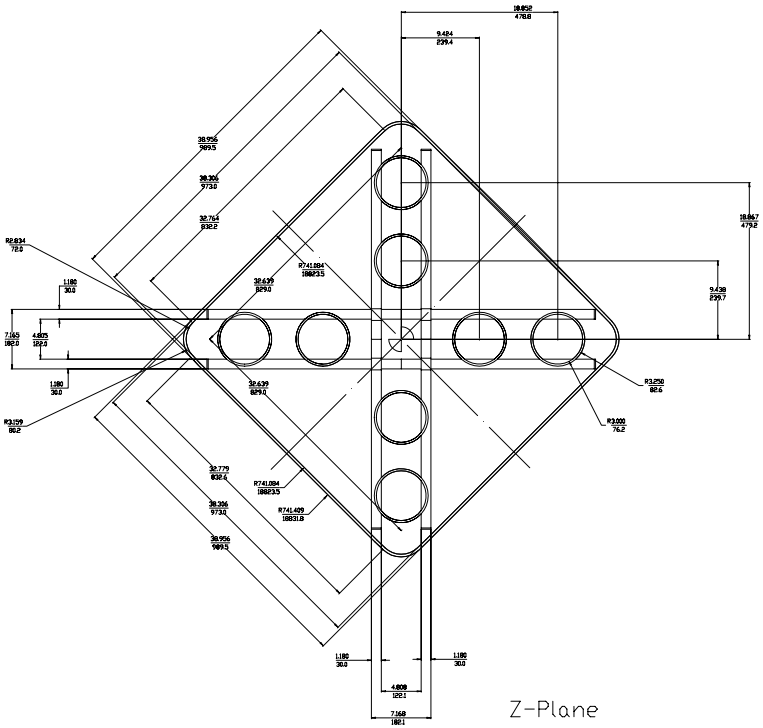

Z-Plane

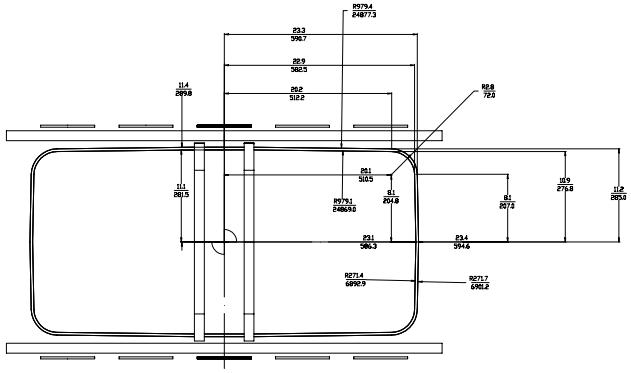

X-Plane

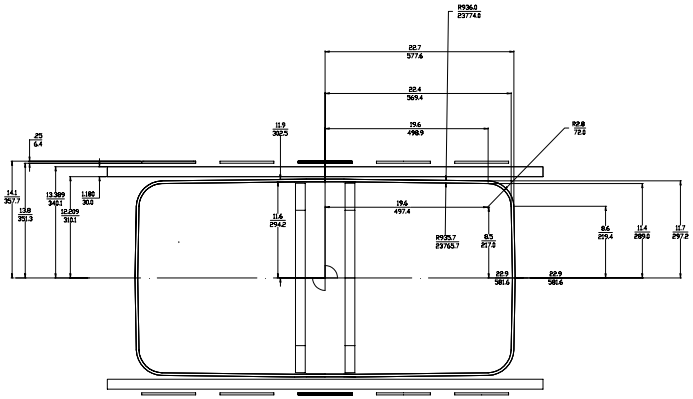

Y-Plane