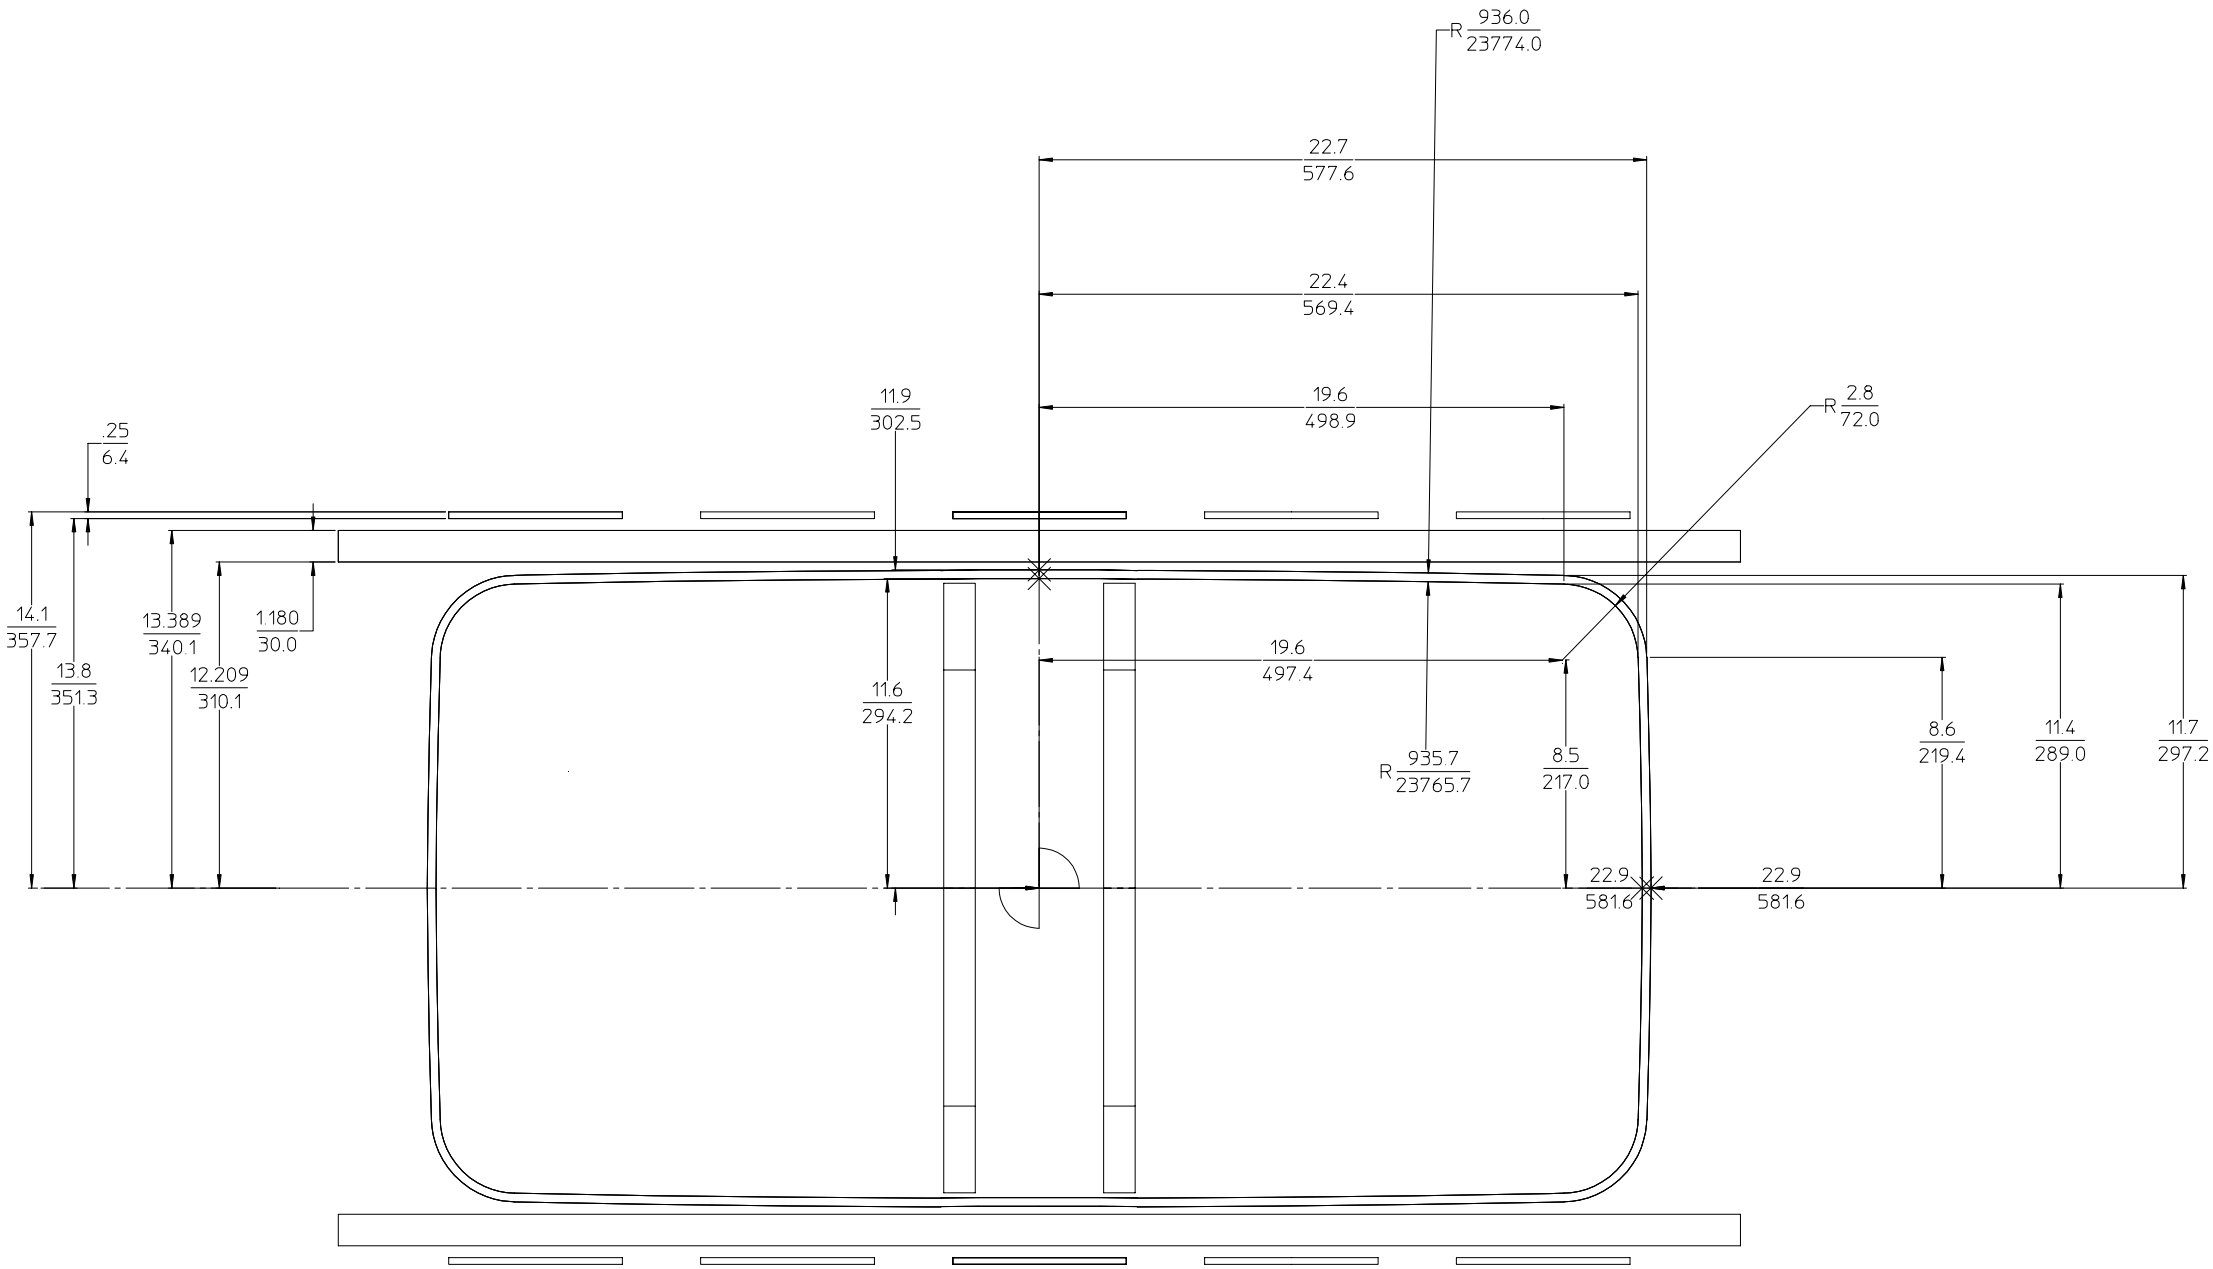
R 936.0 / 23774.0
22.7 / 577.6
22.4 / 569.4
19.6 / 498.9
R 2.8 / 72.0
11.9 / 302.5
.25 / 6.4
14.1 / 357.7
13.389 / 340.1
1.180 / 30.0
13.8 / 351.3
12.209 / 310.1
11.6 / 294.2
19.6 / 497.4
R 935.7 / 23765.7
8.5 / 217.0
8.6 / 219.4
11.4 / 289.0
11.7 / 297.2
22.9 / 581.6
22.9 / 581.6

Y-Plane