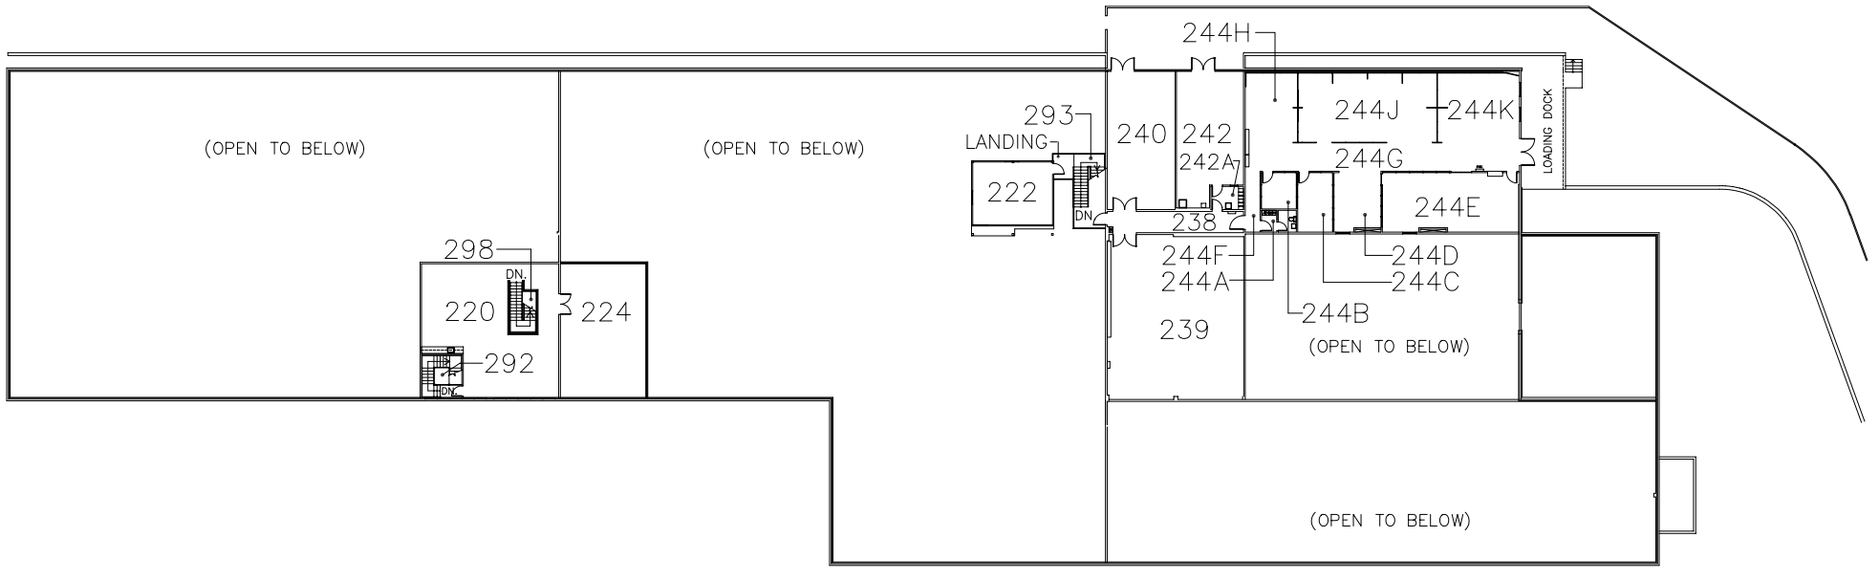

UNIVERSITY OF CALIFORNIA LAWRENCE BERKELEY LABORATORY

FACILITIES DEPARTMENT

0 20 40 80

ASBUILT CONDITION
KEYPLAN

date: 8/12/02

update: W.C

77-2

3 of 3