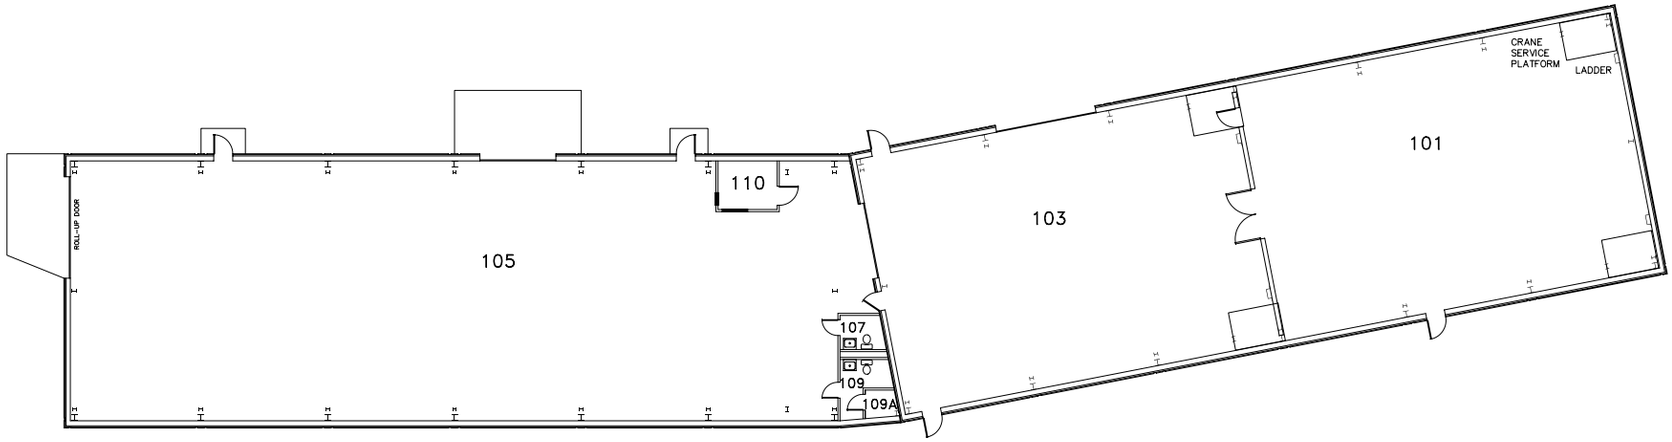


UNIVERSITY OF CALIFORNIA LAWRENCE BERKELEY LABORATORY

**FACILITIES DEPARTMENT**

0 10 20 40

ASBUILT CONDITION
KEYPLAN

date: 10/3/92
check: ESK/WC

# 77A-1